




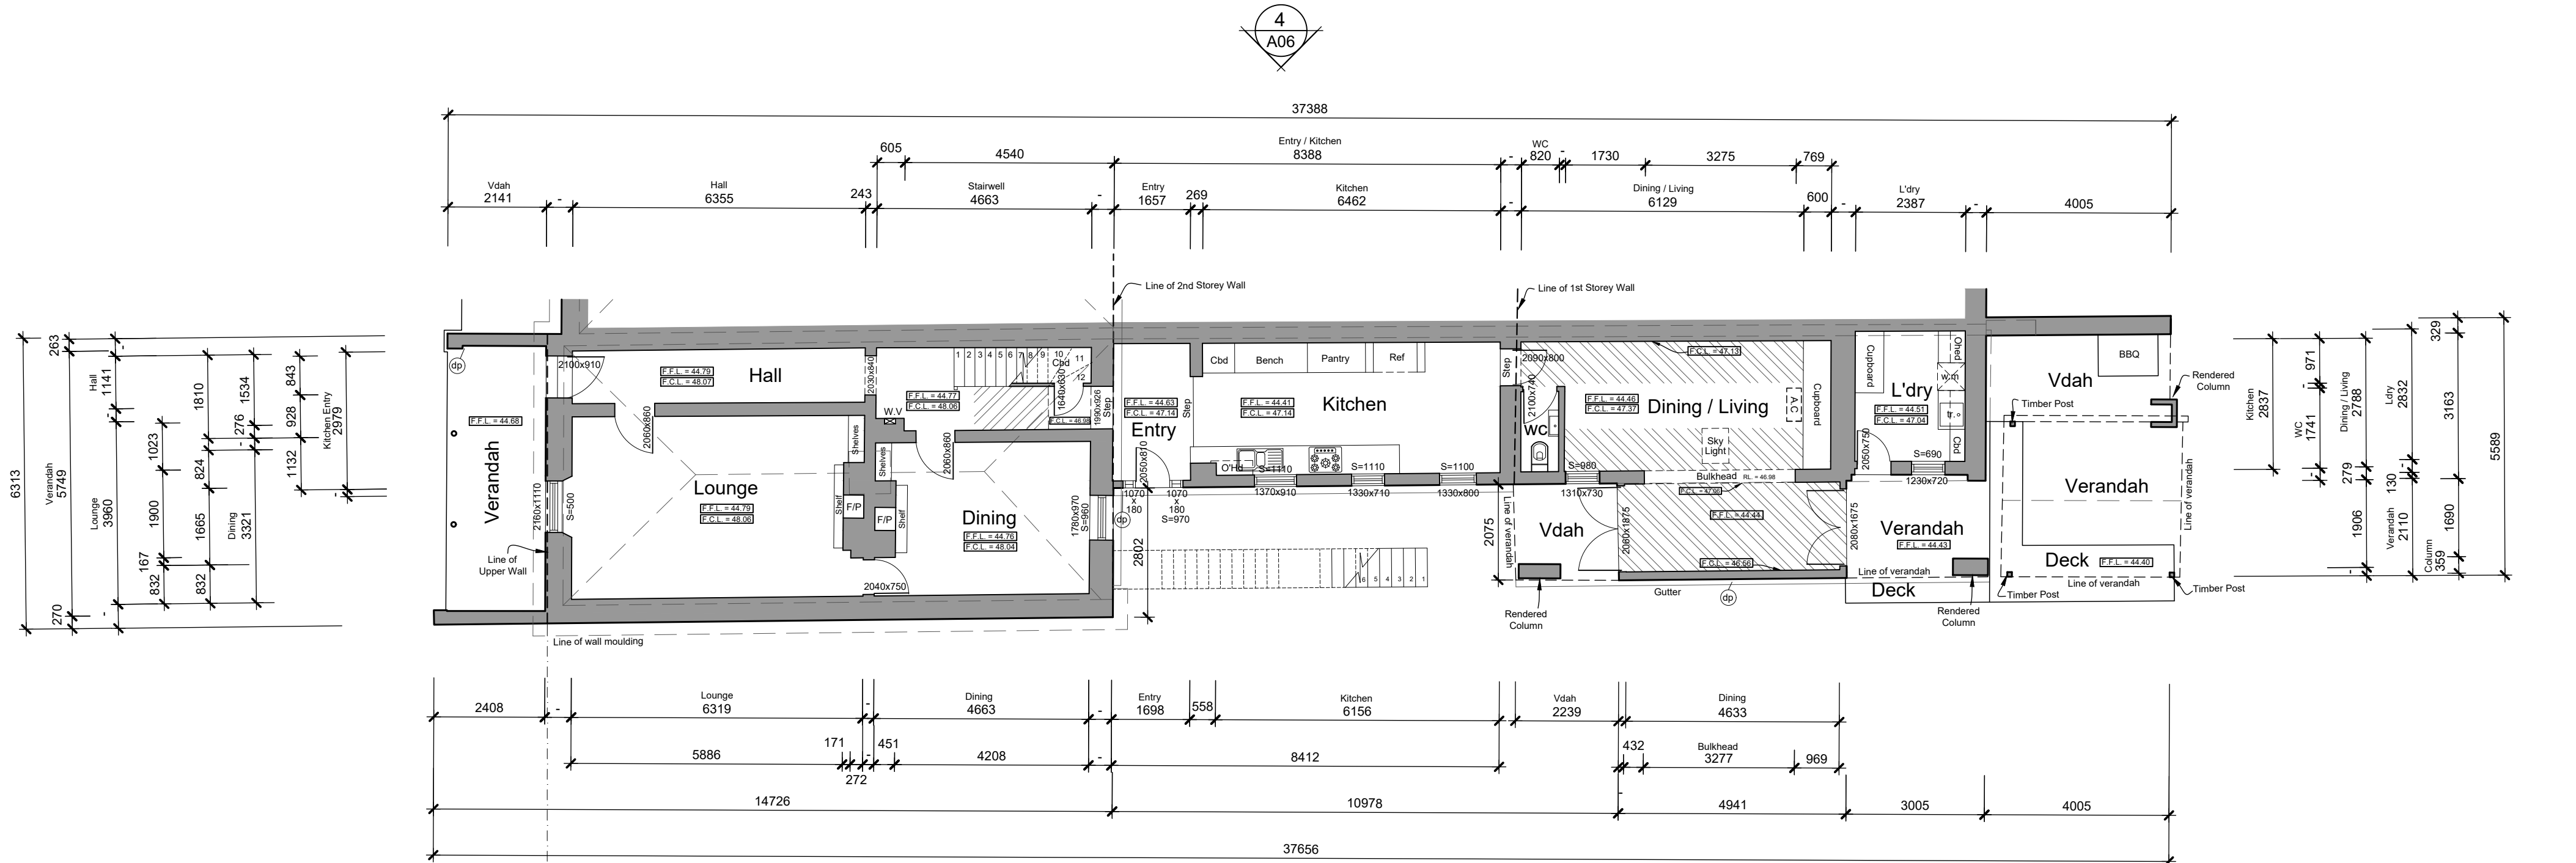


GROUND FLOOR PLAN
SCALE 1 : 100

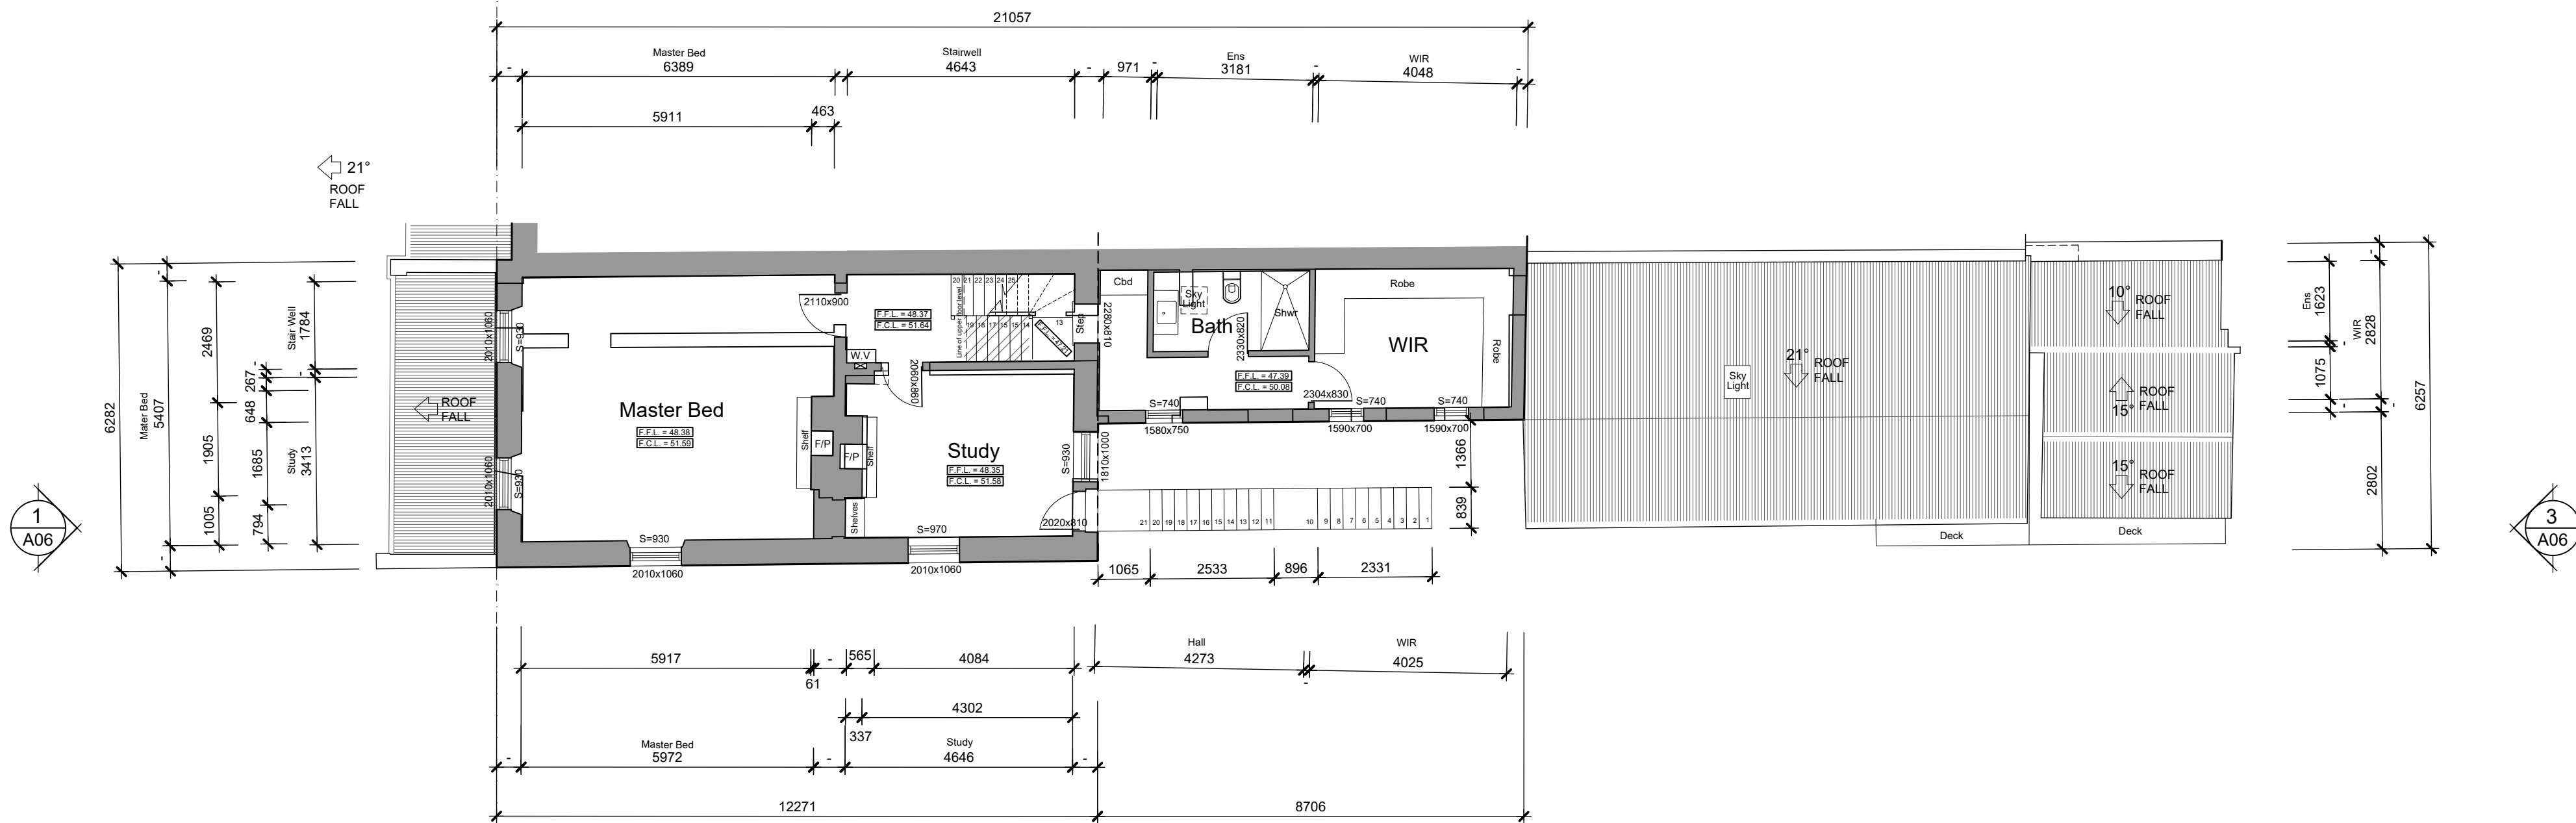

FIRST FLOOR PLAN
SCALE 1 : 100

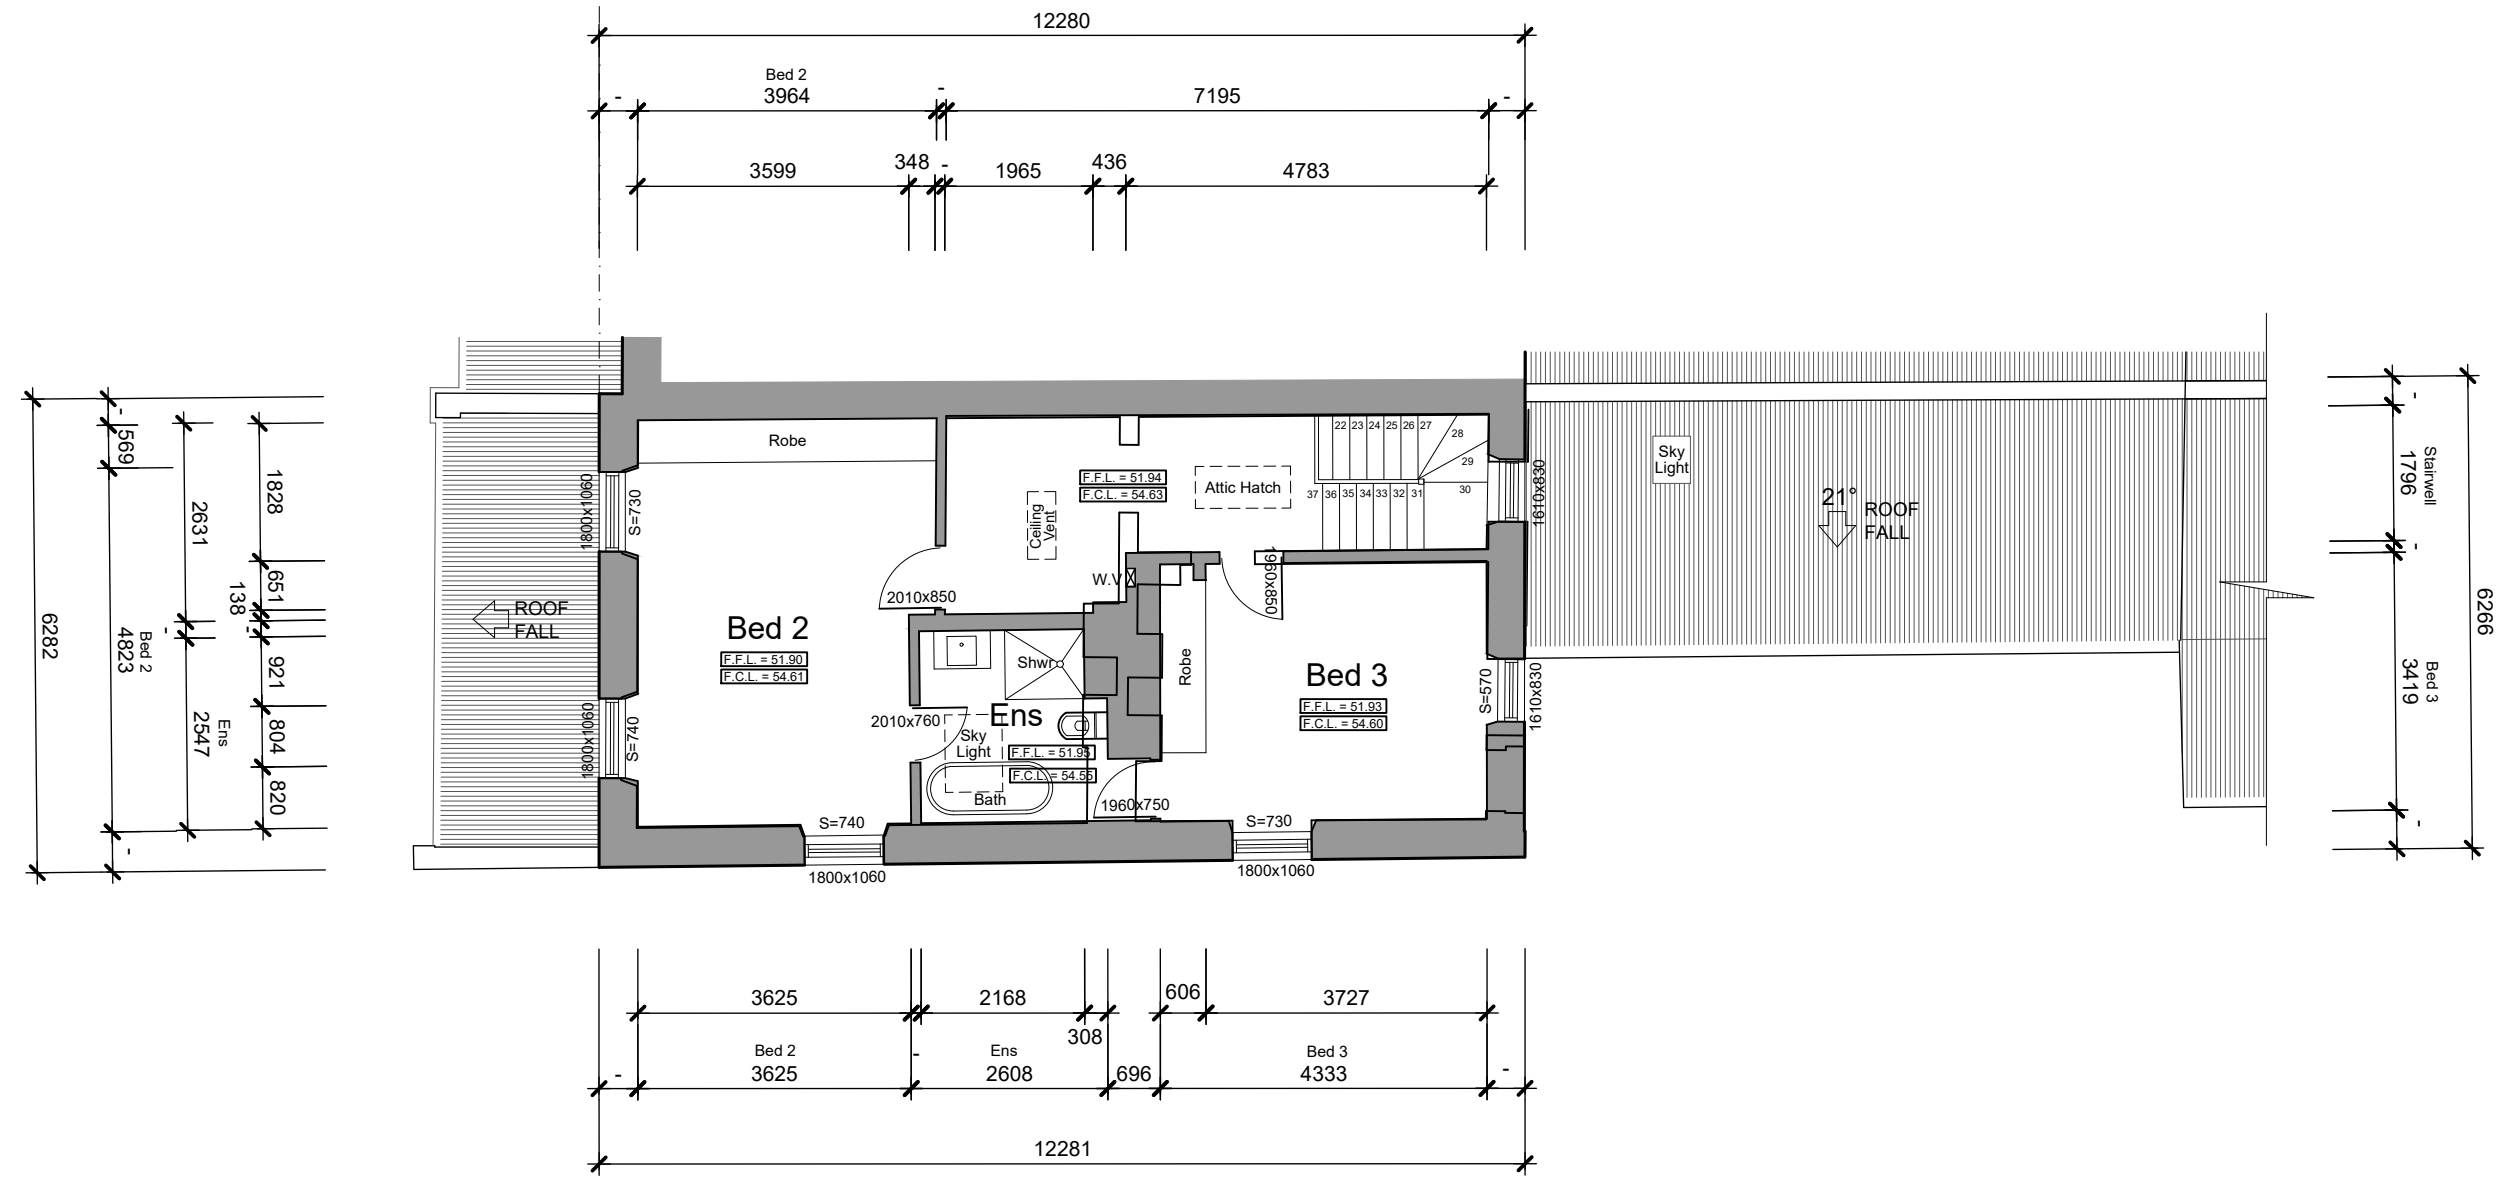


SECOND FLOOR PLAN
SCALE 1 : 100

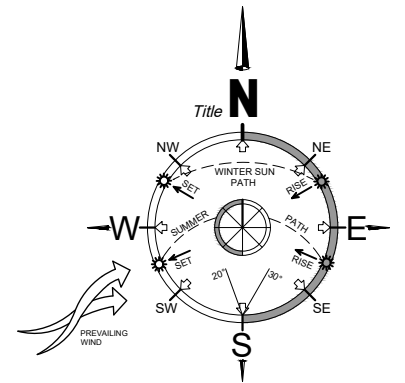

- LEGEND:
- EXISTING WALL
 - EXISTING RAKED / CATHEDRAL CEILING
 - W.V DENOTES INTERNAL MASONRY WALL VENT
 - S = ### SILL HEIGHT IN MILLIMETRES (mm) ABOVE INTERNAL FINISHED FLOOR LEVEL (FFL)
 - dp DENOTES LOCATION OF STORM WATER DOWN PIPES
 - A/C AIR CONDITIONER UNIT

EXISTING FLOOR PLANS
A1 @ SCALE 1 : 100

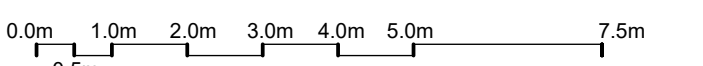

SURVEY NOTES
LEVELS ARE BASED ON AUSTRALIAN HEIGHT DATUM.

EXISTING CONDITIONS ONLY
NOT FOR CONSTRUCTION

Note:
Floor plans have been drawn 'As Built'.
Some Walls may not be square or
perpendicular due to movement or
variations in building construction.

Note:
Measurements as shown
are detailed to Internal
Plasterboard & Cladding.

Note:
All Measurements are to
be Confirmed on Site

ELITE
SITE ANALYSIS
www.elitesiteanalysis.com.au
email: admin@elitesiteanalysis.com.au

AMMENDMENTS:		
Issue	Date	Comments

PROJECT: FEATURE & LEVELS SURVEY.
CLIENT: ELITE Site Analysis.
LOCATION: EXAMPLE ROAD, EXAMPLE
DATE: NA DRAWN: ab TITLE: Final Drawing VERSION: A
JOB NO: Example DWG NO: A0#